


**DETERMINING THE LOCATION OF UNDERGROUND OR EMBEDDED CONDUIT AND CONDUCTOR ON PRIVATE PROPERTY IS THE SOLE RESPONSIBILITY OF THE PROPERTY OWNER**

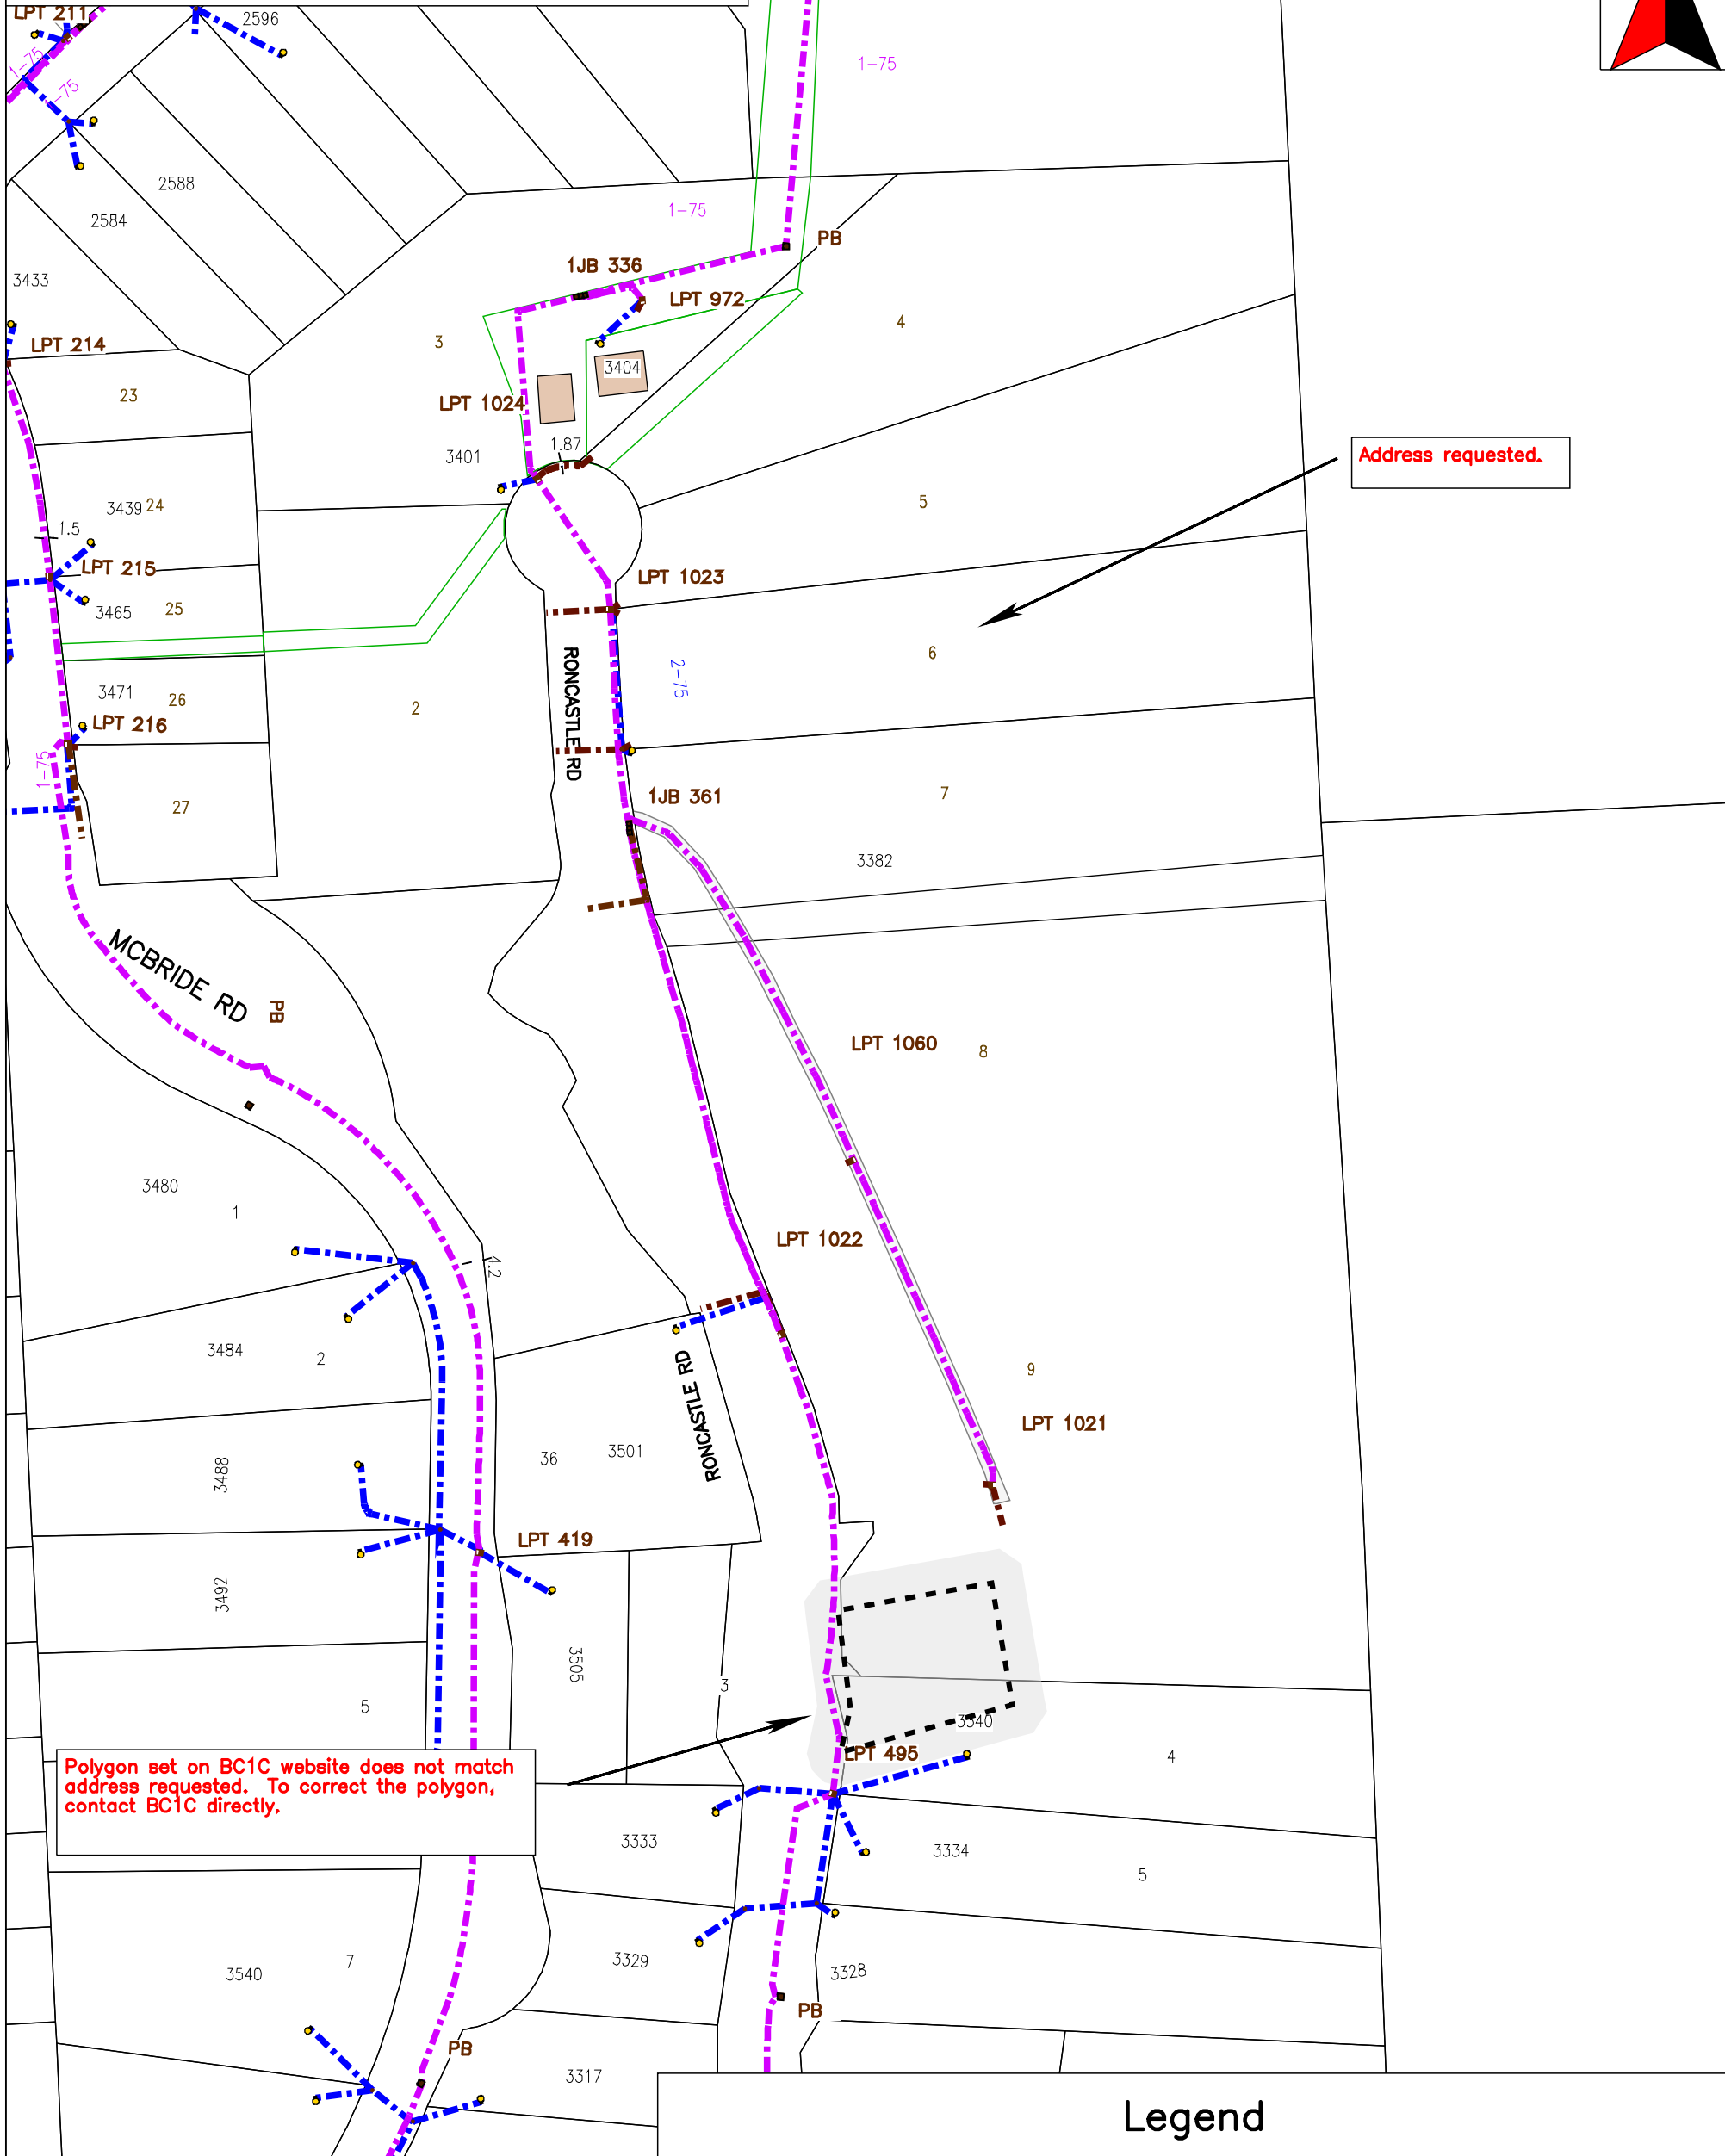

**THIS PRINT IS PROVIDED FOR GENERAL INFORMATION ONLY**  
 BC Hydro does not accept any responsibility for errors or omissions. The information provided is the most accurate information we have available. Beware that underground electrical systems may exist that have not been record "AS CONSTRUCTED" yet.  
 The onus is on the operator to hand dig to locate the actual underground utility before any mechanized digging proceeds.

### Legend

distribution underground [Gis]	U/G Primary
Junction	U/G Primary
Offset Dimension Arrows	U/G Secondary
Offset Dimension Arrows	U/G Secondary
Pull Box	U/G Secondary
Service Box	U/G Transformer