


BC1 Ticket: 20212216971 TINA & NEAL PAULIN  
 Name: MARC DANSEREAU  
 Company: WOOD CREEK CONSTRUCTION LTD  
 Phone No.: 250-832-7893  
 FAX No.:  
 Email: marc@woodcreek.ca

Address: 258 SUNSET DRIVE  
 City: SICAMOUS



IF WORKZONE IS OUTSIDE OF POLYGON SET ON BC1C WEBSITE PLEASE CONTACT BC1C FOR A CORRECTION

2021-06-01

Scale: 1:600

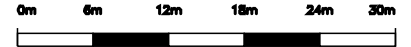

**DETERMINING THE LOCATION OF UNDERGROUND OR EMBEDDED CONDUIT AND CONDUCTOR ON PRIVATE PROPERTY IS THE SOLE RESPONSIBILITY OF THE PROPERTY OWNER**

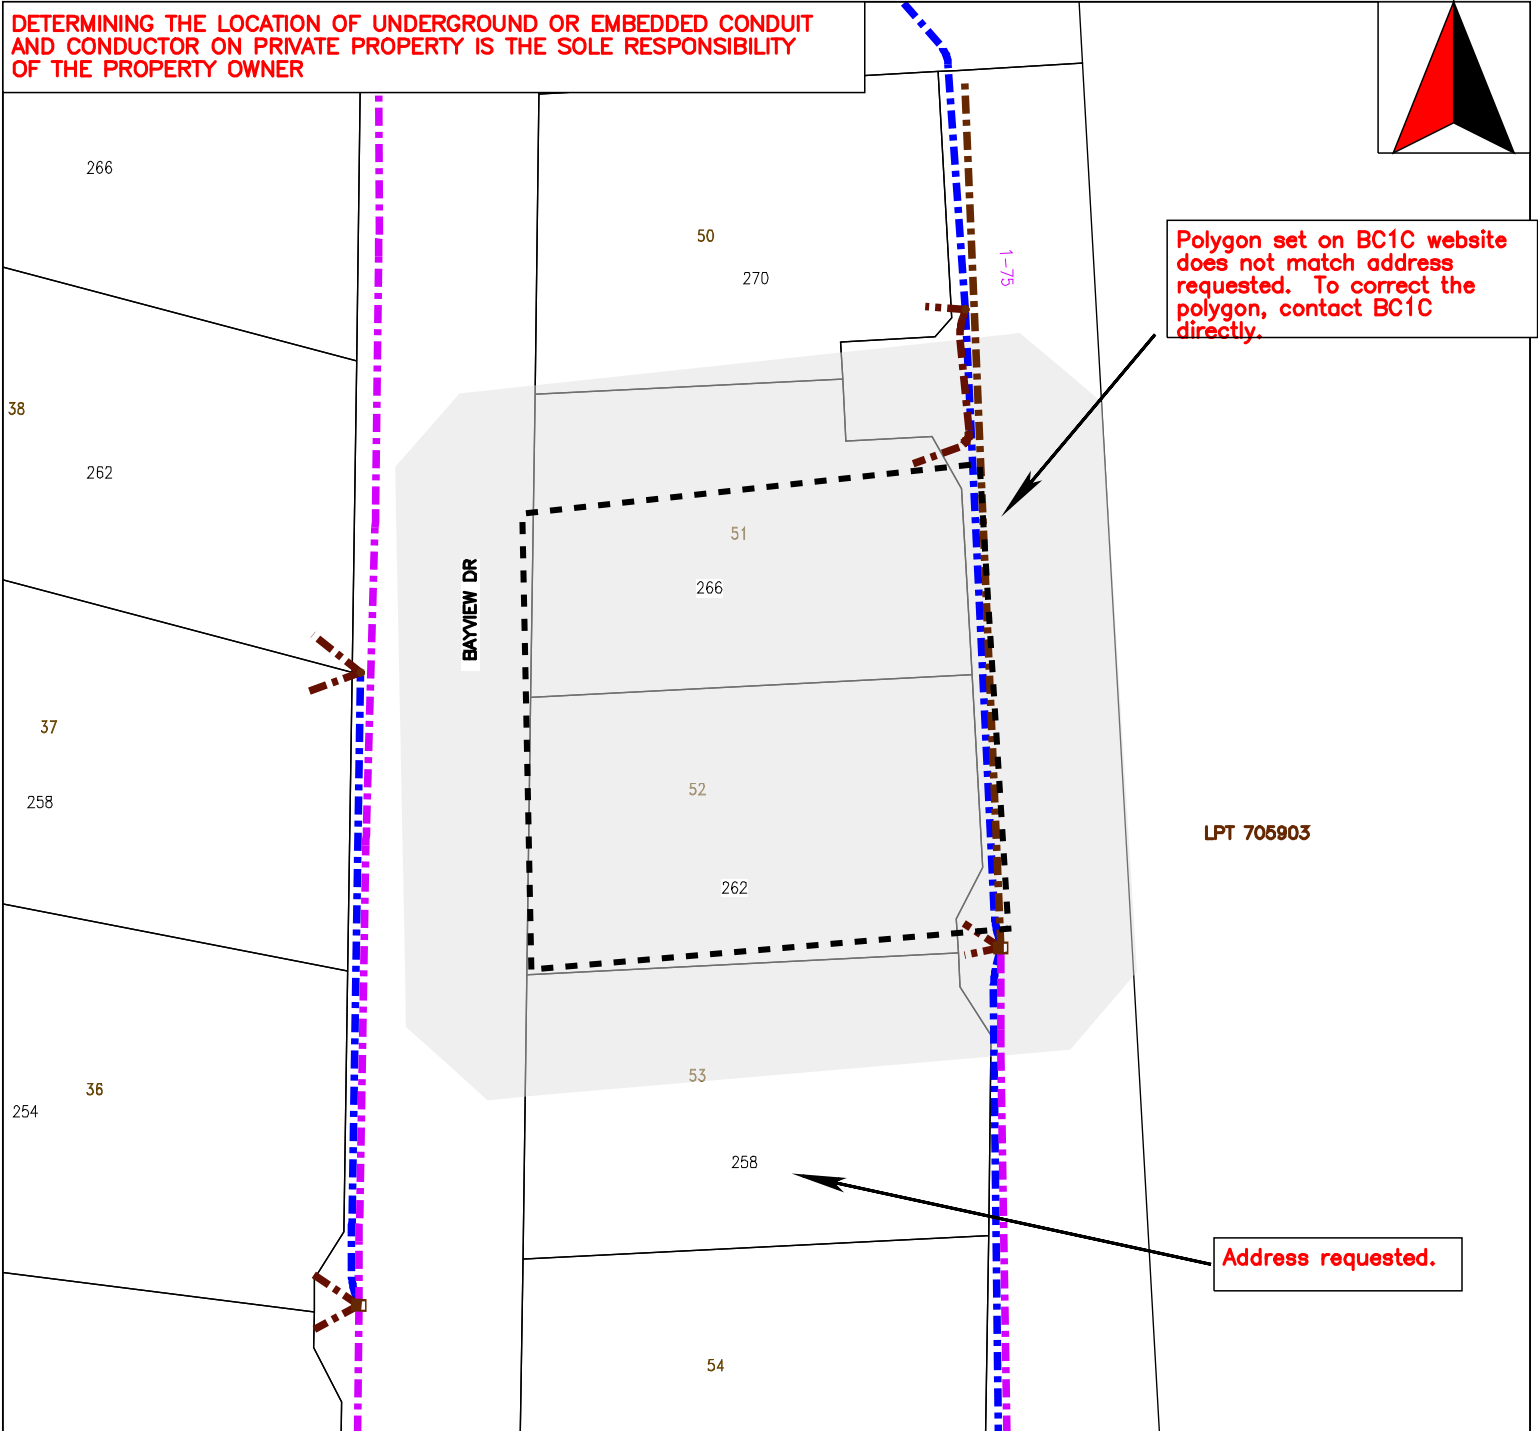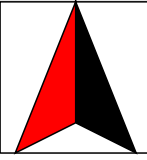

Polygon set on BC1C website does not match address requested. To correct the polygon, contact BC1C directly.

Address requested.

**THIS PRINT IS PROVIDED FOR GENERAL INFORMATION ONLY**

BC Hydro does not accept any responsibility for errors or omissions. The information provided is the most accurate information we have available. Beware that underground electrical systems may exist that have not been record "AS CONSTRUCTED" yet.

The onus is on the operator to hand dig to locate the actual underground utility before any mechanized digging proceeds.

### Legend

● Service Box	■■■■■ U/G Primary	■■■■■ U/G Secondary
■■■■■ U/G Primary	■■■■■ U/G Secondary	■ U/G Transformer
■■■■■ U/G Primary		