


BC1 Ticket: 20212114355 FOOHILL HOUSE 23
 Name: MARC DANSEREAU
 Company: WOOD CREEK CONSTRUCTION LTD
 Phone No.: 250-832-7893
 FAX No.:
 Email: marc@woodcreek.ca
 Address: 210 16 AVE SE
 City: SALMON ARM


IF WORKZONE IS OUTSIDE OF POLYGON SET ON BC1C WEBSITE PLEASE CONTACT BC1C FOR A CORRECTION

2021-05-21

Scale: 1:1000

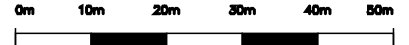

DETERMINING THE LOCATION OF UNDERGROUND OR EMBEDDED CONDUIT AND CONDUCTOR ON PRIVATE PROPERTY IS THE SOLE RESPONSIBILITY OF THE PROPERTY OWNER

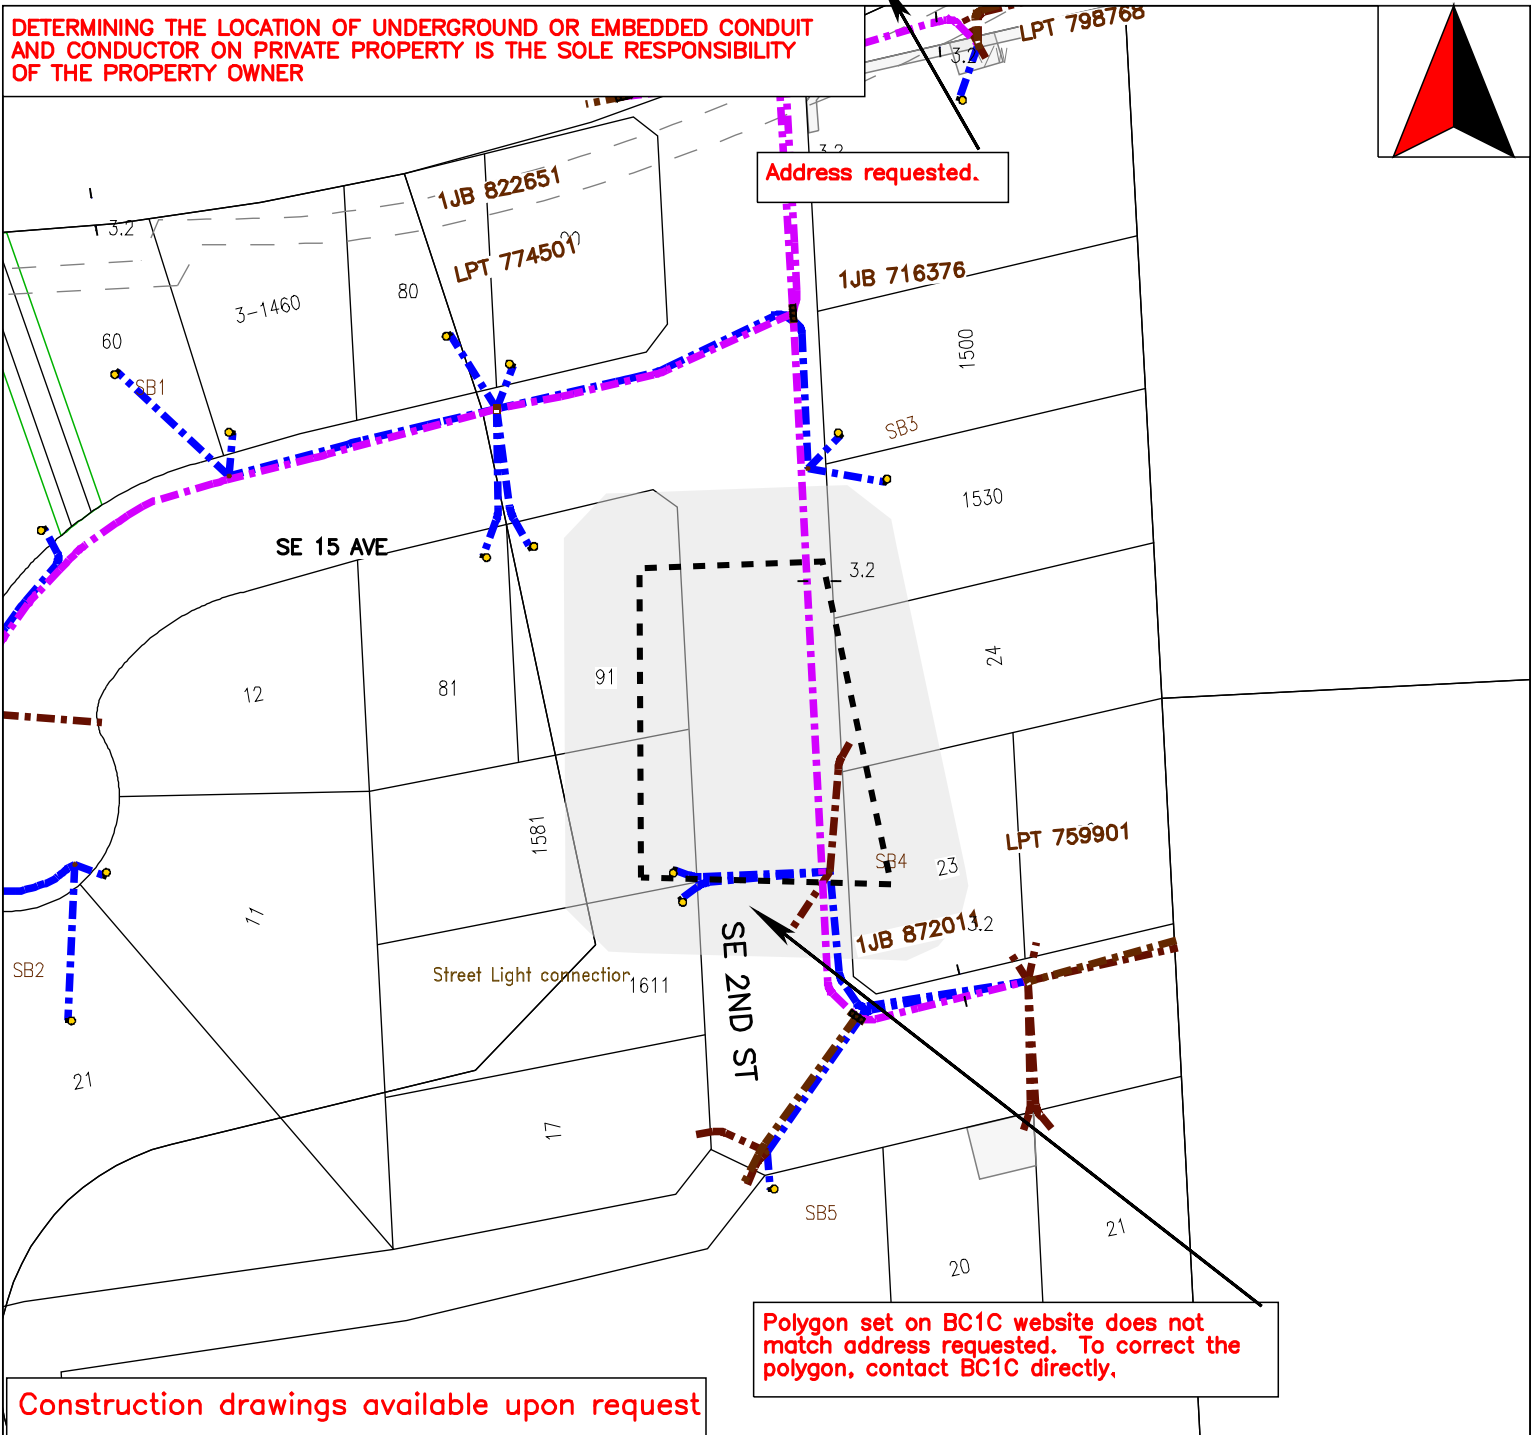

Construction drawings available upon request

THIS PRINT IS PROVIDED FOR GENERAL INFORMATION ONLY
 BC Hydro does not accept any responsibility for errors or omissions. The information provided is the most accurate information we have available. Beware that underground electrical systems may exist that have not been record "AS CONSTRUCTED" yet.
 The onus is on the operator to hand dig to locate the actual underground utility before any mechanized digging proceeds.

Legend

distribution underground [Gts]	U/G Primary
Junction	U/G Primary
Offset Dimension Arrows	U/G Secondary
Offset Dimension Arrows	U/G Secondary
Service Box	U/G Transformer